

LABOR AND MATERIALS

<u>1</u>	Copper } Connection	<u>3/4"</u>	\$	_____
<u>1</u>	Curb } Cock	<u>3/4"</u>	\$	_____
		in.		
<u>1</u>	Service box	{ Short 3-1/2 x 4-1/2	\$	_____
	Old returned	{ Long 4-1/2 x 5-1/2		
<u>25</u>	Ft. <u>3/4</u> in. { Copper		\$	_____
		} Pipe at		
_____	Nipples	_____ in. at	\$	_____
_____	Bushings	_____ to _____ in. at	\$	_____
_____	Red'g			
_____	Inc'g			
_____	Union	_____ in. at	\$	_____
_____	Meter	_____ in. at	\$	_____
_____			\$	_____
_____	Compound Joints at		\$	_____
_____	Maintenance Foreman		\$	_____
_____	Hrs. Water Maint. Man - 1 at		\$	_____
_____	Hrs. Water Maint. Man - 2 at		\$	_____
_____	Hrs. Garage Foreman	_____ at	\$	_____
_____	Hrs. Labor	_____ at	\$	_____
_____	Hrs. Compressor at		\$	_____
_____			\$	_____
_____	Trucking		\$	_____
_____	Pav't Patch		\$	_____
_____			\$	_____
_____			\$	_____

GRANT

Ave. No. 18

Name of Owner

TAX ID # 302.20-1-11

Labor and Mat'l. Report 1926, MAY 21

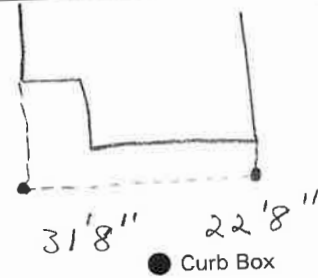

4" Main

Elev. of Main at tap 5'

Gate at ●

● Gate at

● Curb Box