


LABOR AND MATERIALS

1	Copper } Connection	3/4"	\$
1	Lead } Cock		
1	Curb } Valve		
		in.	\$
1	Service box	{ Short 3-1/2 x 4-1/2	\$
	Old returned	{ Long 4-1/2 x 5-1/2	\$
24	Ft. 3/4 in. } Copper		\$
		in.	\$
	Nipples	in. at	\$
	Bushings	to in. at	\$
	Red'g		
	Inc'g		
	Union	in. at	\$
	Meter	in. at	\$
			\$
	Compound Joints at		\$
	Maintenance Foreman		\$
	Hrs. Water Maint. Man - 1 at		\$
	Hrs. Water Maint. Man - 2 at		\$
	Hrs. Garage Foreman at		\$
	Hrs. Labor at		\$
	Hrs. Compressor at		\$
			\$
	Trucking		\$
	Pav't Patch		\$
			\$
			\$
			\$
			\$

GRANT Ave. No. 24
 Name of Owner

Labor and Mat'l. Report 19 35, OCT. 3

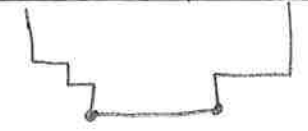

288" 284"

● Curb Box

GRANT AVE. 1

4" Main

Elev. of Main at tap 4 1/2

Gate at ●

● Gate at

● Curb Box

OLD TAP SHUT OFF AT MAIN