

LABOR AND MATERIALS

1	Copper Lead	Connection	3/4"	\$	3.20
1	Curb	Cock Valve T.S. & V.	3/4 in.	\$	1.00
1	Service box Old returned	Short 3 1/2 x 4 1/2 Long 4 1/2 x 5 1/2 Buff or Rdway		\$	1.30
12	Ft.	Copper G.I. C.I.	3/4 in. Pipe at	\$	2.64
	Nipples	in. at		\$	
1	Bushings	3/4 to 1/2 in. at		\$	.07
	Red'g Inc'g	Coupl'gs to in. at		\$	
	Union	in. at		\$	
	Meter	in. at		\$	
	Lead Joints	at		\$	
	Compound Joints	at		\$	
2	Maintenance Foreman		62.5	\$	1.25
	Hrs. Water Maint. Man	—1 at		\$	
	Hrs. Water Maint. Man	—2 at		\$	
	Hrs. Garage Foreman	at		\$	
2	Hrs. Labor	at	50	\$	1.00
7	Hrs. Compressor	at	4.0 5/8	\$	2.84
	Compensation Ins.	at \$ per C		\$	13
Yes	Trucking			\$	1.00
	Pav't Patch			\$	
	No Builders Use of water:			\$	
	O'head			\$	
				\$	14.43

√ 27 - 20.

-St.- 31  
-Pl.-  
Ave. No. 25


Grant

Name of Owner

Biology Florist

Labor and Mat'l. Report

April 27 19 57

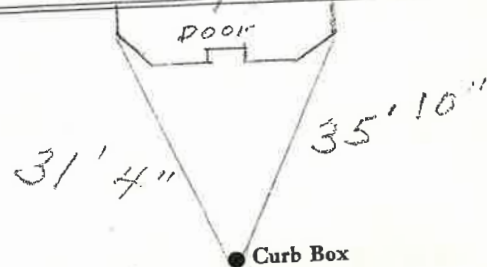

4" Main

Elev. of Main at tap 4'

Gate at ●

● Gate at

TAX ID # 302.19-11-18

● Curb Box

New Building

1959.  
pipe renewed  
from curb box  
to building  
6/59