

LABOR AND MATERIALS


1	Copper } Connection	3/4	\$
1	Lead } Cock		
1	Curb } Valve	3/4 in.	\$
	T.S. & V.		
1	Service box { Short 3-1/2 x 4-1/2		\$
	Old returned { Long 4-1/2 x 5-1/2		
22	Ft. 3/4 in. { Copper		\$
	Est.		
	Pipe at		\$
	Nipples	in. at	\$
	Bushings	to in. at	\$
	Red'g		
	Inc'g		
	Union	in. at	\$
	Meter	in. at	\$
			\$
	Compound Joints at		\$
	Maintenance Foreman		\$
	Hrs. Water Maint. Man - 1 at		\$
	Hrs. Water Maint. Man - 2 at		\$
	Hrs. Garage Foreman at		\$
	Hrs. Labor at		\$
	Hrs. Compressor at		\$
			\$
	Trucking		\$
	Pav't Patch		\$
			\$
			\$
GRANT

Ave. No. 38

Name of Owner

Labor and Mat'l. Report 1930, Oct. 3

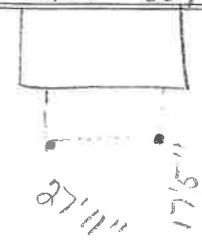

● Curb Box

4" Main

Elev. of Main at tap 5'

Gate at ●

● Gate at

● Curb Box

OLD TAP DISCONNECTED