

LABOR AND MATERIALS


1	Copper Lead	} Connection	3/4		\$	
1	Curb	} Cock Valve T.C. & V.	3/4	in.	\$	
1	Service box Old returned	{ Short 3-1/2 x 4-1/2 Long 4-1/2 x 5-1/2 }			\$	
21	Ft.	3/4 in. { Copper Pipe		} Pipe at	\$	
	Nipples			in. at	\$	
	Bushings			to _____ in. at	\$	
	Red'g				\$	
	Inc'g				\$	
	Union			in. at	\$	
	Meter			in. at	\$	
					\$	
	Compound Joints at				\$	
	Maintenance Foreman				\$	
	Hrs. Water Maint. Man - 1 at				\$	
	Hrs. Water Maint. Man - 2 at				\$	
	Hrs. Garage Foreman			at	\$	
	Hrs. Labor			at	\$	
	Hrs. Compressor at				\$	
					\$	
	Trucking				\$	
	Pav't Patch				\$	
					\$	
					\$	
GRANT

St. Ave. No. 40

Name of Owner

Labor and Mat'l. Report 1933, AUG. 3

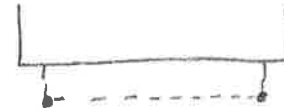

29 24-4

● Curb Box

4" Main

Elev. of Main at tap 4 1/2'

Gate at ●

● Gate at

● Curb Box

OLD TAP SHUT OFF AT
MAIN