


LABOR AND MATERIALS

1	Copper } Connection	3/4	\$
1	Lead } Cock Valve } F.S. & V. }	3/4 in.	\$
1	Service box } Old returned }	{ Short 3-1/2 x 4-1/2 } { Long 4-1/2 x 5-1/2 }	\$
12	Ft. 3/4 in. } Copper } Gal. }	Pipe at	\$
	Nipples	in. at	\$
	Bushings	to in. at	\$
	Red'g		
	Inc'g		
	Union	in. at	\$
	Meter	in. at	\$
			\$
	Compound Joints at		\$
	Maintenance Foreman		\$
	Hrs. Water Maint. Man - 1 at		\$
	Hrs. Water Maint. Man - 2 at		\$
	Hrs. Garage Foreman at		\$
	Hrs. Labor at		\$
	Hrs. Compressor at		\$
			\$
	Trucking		\$
	Pav't Patch		\$
			\$
			\$
			\$
			\$

GRANT St. Pt. Ave. No. 42
Name of Owner

Labor and Mat'l. Report 19 27 June 20

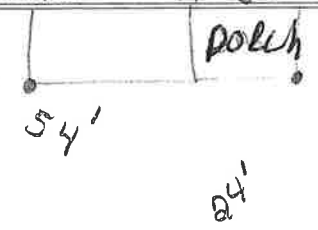

CRANDALL ST.
10" Main Elev. of Main at tap 4'
Gate at ● Gate at ●

● Curb Box
OLD TAP SHUT OFF