


LABOR AND MATERIALS

1	Copper	} Connection	3/4"	\$	
	Lead				
1	Curb	} T.S. & V.	3/4 in.	\$	
	Cock				
	Valve				
1	Service box	} Short 3 1/2 x 4 1/2		\$	
	Old returned				Long 4 1/2 x 5 1/2
		} Buff or Rdway		\$	
13	Ft	} Copper	3/4 in.	\$	
					G.I.
		} Pipe at		\$	
	Nipples	in.	at	\$	
	Bushings	to	in.	at	\$
	Red'g	} Coupl'gs	to	in.	at
	Inc'g				
	Union	in.	at	\$	
	Meter	in.	at	\$	
	Lead Joints	at		\$	
	Compound Joints	at		\$	
	Maintenance Foreman	at		\$	
	Hrs. Water Maint. Man-1	at		\$	
	Hrs. Water Maint. Man-2	at		\$	
	Hrs. Garage Foreman	at		\$	
	Hrs. Labor	at		\$	
	Hrs. Compressor	at		\$	
	Compensation Ins.	at \$	per C	\$	
	Trucking			\$	
	Pav't Patch			\$	
	Tap by Giffard & Co.			\$	
	12-30-58.			\$	
	O'head			\$	

Grant Ave. No. 47
 Name of Owner
 Robt. G. Adams

Labor and Mat'l. Report Dec. 30 1958

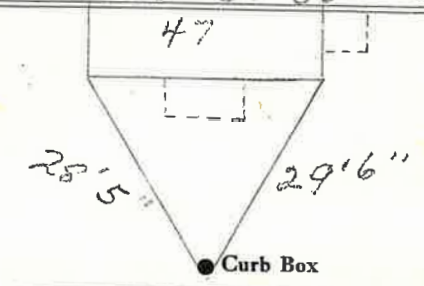

4" Main Elev. of Main at tap 4"

Gate at • Gate at

TAX ID # 302.19-10-12

• Curb Box