

LABOR AND MATERIALS


1	Copper } Connection	3/4	\$	_____
	Lead }			
1	Curb } Cock	3/4 in.	\$	_____
	Valve }			
	F.S. & V. }			
1	Service box { Short 3-1/2 x 4-1/2		\$	_____
	Old returned { Long 4-1/2 x 5-1/2			
19	Ft. 3/4 in. { Copper	} Pipe at	\$	_____
	Galv. }			
	Cl. }			
_____	Nipples _____	in. at _____	\$	_____
_____	Bushings _____	to _____ in. at _____	\$	_____
_____	Red'g _____			
_____	Inc'g _____			
_____	Union _____	in. at _____	\$	_____
_____	Meter _____	in. at _____	\$	_____
_____			\$	_____
_____	Compound Joints at _____		\$	_____
_____	Maintenance Foreman _____		\$	_____
_____	Hrs. Water Maint. Man - 1 at _____		\$	_____
_____	Hrs. Water Maint. Man - 2 at _____		\$	_____
_____	Hrs. Garage Foreman _____	at _____	\$	_____
_____	Hrs. Labor _____	at _____	\$	_____
_____	Hrs. Compressor at _____		\$	_____
_____			\$	_____
_____	Trucking _____		\$	_____
_____	Pav't Patch _____		\$	_____
_____			\$	_____
_____			\$	_____
GRANT

St. Pt. Ave. No. 9

Name of Owner

Labor and Mat'l. Report 19 35, Oct. 8

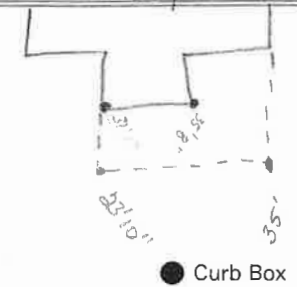

4" Main

Elev. of Main at tap 4 1/2'

Gate at ●

● Gate at

TAX ID # 302.15-14-27

● Curb Box

OLD TAP SHUT OFF AT MAIN