

LABOR AND MATERIALS


1	Copper Lead	} Connection	3/4		\$	
1	Curb	} Cock Valve T.S. & V.	3/4 in.		\$	
1	Service box	{ Short 3-1/2 x 4-1/2 Old returned Long 4-1/2 x 5-1/2			\$	
23	Ft. 3/4 in.	{ Copper Gal.		} Pipe at	\$	
	Nipples			in. at	\$	
	Bushings			to in. at	\$	
	Red'g				\$	
	Inc'g				\$	
	Union			in. at	\$	
	Meter			in. at	\$	
					\$	
	Compound Joints			at	\$	
	Maintenance Foreman				\$	
	Hrs. Water Maint. Man - 1			at	\$	
	Hrs. Water Maint. Man - 2			at	\$	
	Hrs. Garage Foreman			at	\$	
	Hrs. Labor			at	\$	
	Hrs. Compressor			at	\$	
					\$	
	Trucking				\$	
	Pav't Patch				\$	
					\$	
					\$	
GRANT

St. _____
Pl. _____ Ave. No. 54

Name of Owner _____

Labor and Mat'l. Report 19 29, July 11

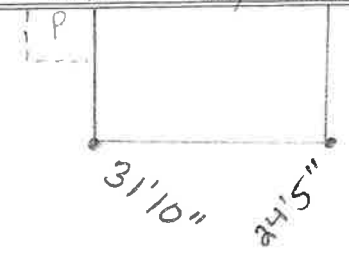

4" Main

Elev. of Main at tap 4'1/2

Gate at ●

● Gate at

● Curb Box

OLD TAP DISCONNECTED