

LABOR AND MATERIALS


1 Copper } Connection 3/4 \$ _____
 1 Lead }
 1 Curb } Cock } 3/4 in. \$ _____
 1 } Valve }
 1 } T.S. & V. }
 1 Service box { Short 3-1/2 x 4-1/2 } \$ _____
 1 Old returned { Long 4-1/2 x 5-1/2 } \$ _____
24 Ft. 3/4 in. { Copper } Pipe at _____ \$ _____
 { S.T. }
 { S.T. }
 _____ Nipples _____ in. at _____ \$ _____
 _____ Bushings _____ to _____ in. at _____ \$ _____
 _____ Red'g _____
 _____ Inc'g _____
 _____ Union _____ in. at _____ \$ _____
 _____ Meter _____ in. at _____ \$ _____
 _____ \$ _____
 _____ Compound Joints at _____ \$ _____
 _____ Maintenance Foreman _____ \$ _____
 _____ Hrs. Water Maint. Man - 1 at _____ \$ _____
 _____ Hrs. Water Maint. Man - 2 at _____ \$ _____
 _____ Hrs. Garage Foreman _____ at _____ \$ _____
 _____ Hrs. Labor _____ at _____ \$ _____
 _____ Hrs. Compressor at _____ \$ _____
 _____ \$ _____
 _____ \$ _____
 _____ Trucking _____ \$ _____
 _____ Pav't Patch _____ \$ _____
 _____ \$ _____
 _____ \$ _____
GRANT

St. Ave. No. 56

Name of Owner

Labor and Mat'l. Report 1932, Sept. 8

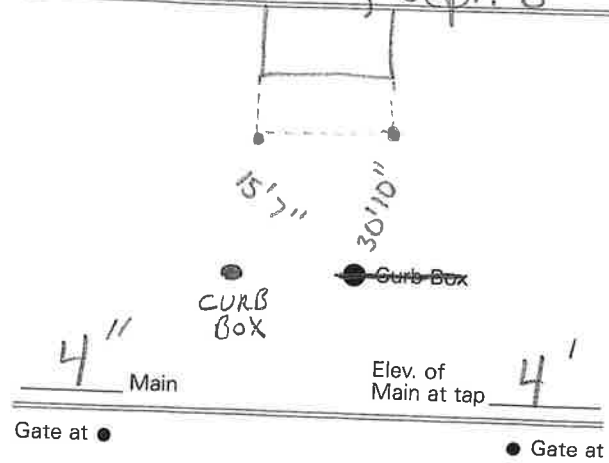

4" Main

Elev. of Main at tap 4'

Gate at ●

● Gate at

● Curb Box

OLD TAP SHUT OFF