

LABOR AND MATERIALS


1 Copper } Connection $\frac{3}{4}$ \$ _____
~~1~~ Curb } Cock } $\frac{3}{4}$ in. \$ _____
 } Valve }
 } T.C. & V. }
 1 Service box { Short 3-1/2 x 4-1/2 } \$ _____
 Old returned { Long 4-1/2 x 5-1/2 }
 25 Ft. $\frac{3}{4}$ in. { Copper } Pipe at \$ _____
 _____ Nipples _____ in. at \$ _____
 _____ Bushings _____ to _____ in. at \$ _____
 _____ Red'g _____
 _____ Inc'g _____
 _____ Union _____ in. at \$ _____
 _____ Meter _____ in. at \$ _____
 _____ \$ _____
 _____ Compound Joints at \$ _____
 _____ Maintenance Foreman \$ _____
 _____ Hrs. Water Maint. Man - 1 at \$ _____
 _____ Hrs. Water Maint. Man - 2 at \$ _____
 _____ Hrs. Garage Foreman _____ at \$ _____
 _____ Hrs. Labor _____ at \$ _____
 _____ Hrs. Compressor at \$ _____
 _____ \$ _____
 _____ Trucking \$ _____
 _____ Pav't Patch \$ _____
 _____ \$ _____
 _____ \$ _____
GRANT

Ave. No. 67

Name of Owner

Labor and Mat'l. Report 1933, JULY 11

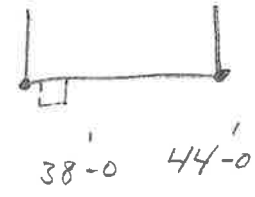

● Curb Box

6" Main

Elev. of Main at tap $4\frac{1}{2}$

Gate at ●

● Gate at

● Curb Box