

LABOR AND MATERIALS


1	Copper	} Connection $\frac{3}{4}$ "	\$
	Lead		
1	Curb	} Cock Valve $\frac{3}{4}$ in. OYISEA1	\$
1	Service box	} Short $3\frac{1}{2}$ x $4\frac{1}{2}$ Long $4\frac{1}{2}$ x $5\frac{1}{2}$ Buff or Redway } 4' x 5'	\$
	Old returned		
12	$\frac{3}{4}$ in.	} Copper Pipe at	\$
	Nipples	in. at	\$
	Bushings	to in. at	\$
	Red'g		
	Inc'g	} Coupl'gs to in. at	\$
	Union	in. at	\$
	Meter	in. at	\$
	Lead Joints	at	\$
	Compound Joints	at	\$
	Maintenance Foreman		\$
	Hrs. Water Maint. Man—1	at	\$
	Hrs. Water Maint. Man—2	at	\$
	Hrs. Garage Foreman	at	\$
	Hrs. Labor—	at	\$
	Hrs. Compressor	at	\$
	Compensation Ins. at \$	per C	\$
	Trucking		\$
	Pav't Patch		\$
	TAP BY PIERVIS & CO		\$
	OCT-17-1975		\$
	O'head		\$

31'5" of Copper - June '91

GRANT SE  
PT  
Ave. No. 72

Name of Owner  
FRANK ENDIEVERI

Labor and Mat'l. Report Oct 17 1975

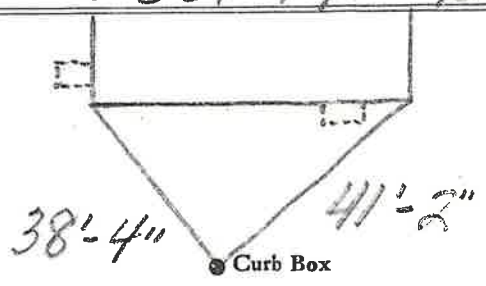

6" Main Elev. of Main at tap 4 1/2'

Gate at • • Gate at

