


LABOR AND MATERIALS

1 Copper Connection $3/4"$ \$
~~Lead~~ }
 1 Curb Cock Valve } $5/4$ in. MARK II OR \$ SEAL
 1 Service box { Short $3/2 \times 4/2$ } $4' \times 5'$
 Old returned { Long $4/2 \times 5/2$ }
 { Buff or Rdway }
 11 Ft. $3/4$ in. { Copper } Pipe at \$
 { Gal. }
 Nipples in. at \$
 Bushings to in. at \$
 Red'g } Coupl'gs to in. at \$
 Inc'g }
 Union in. at \$
 Meter in. at \$
 Lead Joints at \$
 Compound Joints at \$
 Maintenance Foreman \$
 Hrs. Water Maint. Man-1 at \$
 Hrs. Water Maint. Man-2 at \$
 Hrs. Garage Foreman at \$
 Hrs. Labor at \$
 Hrs. Compressor at \$
 Compensation Ins. at \$ per C \$
 Trucking \$
 Pav't Patch \$
 Tape made by \$
 St. John \$
 O'head $Oct-4-1972$ \$

GRANT St. Ave. No. 76

Name of Owner Steward

Labor and Mat'l. Report Oct. 4 1972

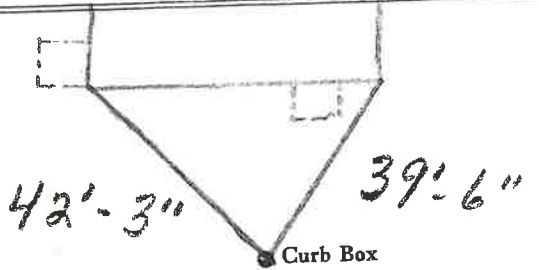

6" Main Elev. of Main at tap $5 \frac{1}{2}'$

Gate at • Gate at •

• Curb Box