

LABOR AND MATERIALS


1	Copper } Connection	3/4"	\$	
1	Lead } Cock Valve	3/4" in.	\$	
1	Curb } T.O. & V.		\$	
1	Service box	{ Short 3-1/2 x 4-1/2	\$	
	Old returned	{ Long 4-1/2 x 5-1/2	\$	
25	Ft. 3/4" in. { Copper		\$	
		{ Gal.		
		{ Gal.		
	Pipe at		\$	
	Nipples	in. at	\$	
	Bushings	to in. at	\$	
	Red'g		\$	
	Inc'g		\$	
	Union	in. at	\$	
	Meter	in. at	\$	
			\$	
	Compound Joints at		\$	
	Maintenance Foreman		\$	
	Hrs. Water Maint. Man - 1 at		\$	
	Hrs. Water Maint. Man - 2 at		\$	
	Hrs. Garage Foreman	at	\$	
	Hrs. Labor	at	\$	
	Hrs. Compressor at		\$	
			\$	
	Trucking		\$	
	Pav't Patch		\$	
			\$	
			\$	
GRANT

Ave. No. 77

Name of Owner
TAX ID # 302.19-9-10

Labor and Mat'l. Report 19 35, OCT. 22

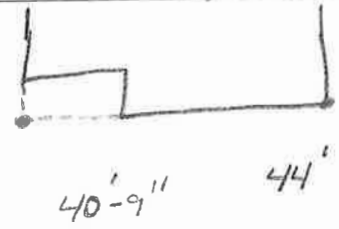

● Curb Box

6" Main

Elev. of Main at tap 4'

Gate at ● ● Gate at

● Curb Box