


# LABOR AND MATERIALS

1	Copper } Connection <u>3/4</u>	\$ _____
	Lead }	
1	Curb } Cock Valve } <u>3/4</u> in.	\$ _____
1	Service box { Short 3-1/2 x 4-1/2 }	\$ _____
	Old returned { Long 4-1/2 x 5-1/2 }	\$ _____
25	Ft. <u>3/4</u> in. { Copper } Pipe at	\$ _____
	Nipples _____ in. at	\$ _____
	Bushings _____ to _____ in. at	\$ _____
	Red'g	
	Inc'g	
	Union _____ in. at	\$ _____
	Meter _____ in. at	\$ _____
		\$ _____
	Compound Joints at	\$ _____
	Maintenance Foreman	\$ _____
	Hrs. Water Maint. Man - 1 at	\$ _____
	Hrs. Water Maint. Man - 2 at	\$ _____
	Hrs. Garage Foreman _____ at	\$ _____
	Hrs. Labor _____ at	\$ _____
	Hrs. Compressor at	\$ _____
		\$ _____
	Trucking	\$ _____
	Pav't Patch	\$ _____
		\$ _____
		\$ _____
GRANT St. Ave. No. 79  
 Name of Owner \_\_\_\_\_

Labor and Mat'l. Report 19 32, MAR. 14

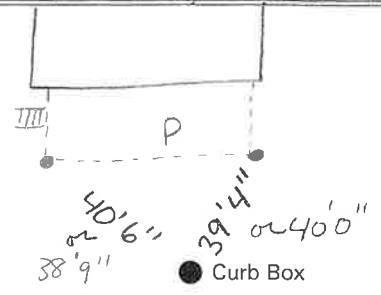

6" Main Elev. of Main at tap 5'

Gate at ● Gate at ●  
 ● Curb Box