


## LABOR AND MATERIALS

Copper	}	Connection	-----	\$	
Lead			-----	\$	
Curb	}	Cock Valve T. S. & V.	-----	in. ----- \$	
Service Box			}	Short 3 1/2 x 4 1/2	\$
Old returned				Long 4 1/2 x 5 1/2	
		Buff. or Rdway	-----		
Ft. -----	}	Pipe at	-----	\$	
in. -----			Copper	-----	
			Galv Iron	-----	
		Cast Iron	-----		
Nipples	in. at	\$	-----		
Bushings	to -----	in. at	-----	\$	
Red'g Inc'g	}	Couplings	-----	to -----	
			-----	in. at	\$
Union	in. at	\$	-----		
Meter	in. at	\$	-----		
Lead Joints	at	\$	-----		
Leadite Joints	at	\$	-----		
Hrs. Foreman	at	\$	-----		
Hrs. Chauffeur	at	\$	-----		
Hrs. Tapper	at	\$	-----		
Hrs. Labor	at	\$	-----		
Hrs. Labor	at	\$	-----		
Hrs. Compressor	at	\$	-----		
Compensation Ins.	at	\$	-----		
Trucking	at	\$	-----		
Builders Use of Water	at	\$	-----		
	at	\$	-----		
	at	\$	-----		
St. \_\_\_\_\_  
Pt. \_\_\_\_\_  
Ave. No. 82

Name of Owner \_\_\_\_\_  
\_\_\_\_\_

Labor and Mat'l. Report AUG. 22 1939

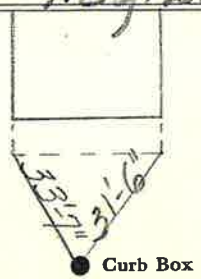

Main	Elev. of Main at tap
Gate at ●	● Gate at

● Curb Box