

LABOR AND MATERIALS


1 Copper } Connection 3/4 \$ _____
 Lead }
 1 Curb } Cock } 3/4 in. \$ _____
 } Valve- }
 } T.S. & V. }
 1 Service box { Short 3-1/2 x 4-1/2 } \$ _____
 Old returned { Long 4-1/2 x 5-1/2 }
26 Ft. 3/4 in. { Copper } Pipe at \$ _____
 } G.I. }
 } G.I. }
 _____ Nipples _____ in. at \$ _____
 _____ Bushings _____ to _____ in. at \$ _____
 _____ Red'g _____
 _____ Inc'g _____
 _____ Union _____ in. at \$ _____
 _____ Meter _____ in. at \$ _____
 _____ \$ _____
 _____ Compound Joints at \$ _____
 _____ Maintenance Foreman \$ _____
 _____ Hrs. Water Maint. Man - 1 at \$ _____
 _____ Hrs. Water Maint. Man - 2 at \$ _____
 _____ Hrs. Garage Foreman _____ at \$ _____
 _____ Hrs. Labor _____ at \$ _____
 _____ Hrs. Compressor at \$ _____
 _____ \$ _____
 _____ Trucking \$ _____
 _____ Pav't Patch \$ _____
 _____ \$ _____
 _____ \$ _____
GRANT

St. _____
 Pt. 83
 Ave. No. _____

Name of Owner _____

Labor and Mat'l. Report 19 29, July 22

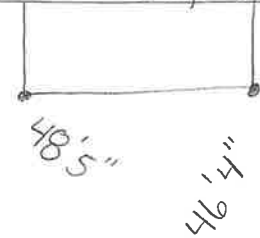

● Curb Box

6 Main

Elev. of Main at tap 5

Gate at ●

● Gate at

● Curb Box

NEW HOUSE

Labor and Materials


1	Copper	} Connection 3/4"	\$ 1.25	
1	Lead				
1	Curb	{ Cock Valve T.S.&V. }	} 3 1/2" in	\$ 1.70
1	Service Box				
1	Old returned	{ Short 3 1/2 x 4 1/2 Long 4 1/2 x 5 1/2 Buff. or Rdway }	}	\$ 1.45	
29	Ft. 3/4" in				{ Copper Galv. Iron Cast Iron }
	Nipples in. at	\$		
	Bushings to	in. at	\$	
	Red'g Inc'g	{ Couplings to	in. at	\$
	Union				
	Meter in. at	\$		
	Lbs. Br. Stone	at	\$		
	Lbs. Sand	at	\$		
	Bags Cement	at	\$		
	Paving Brick	{ Mack Red Asphalt }	} at	\$	
	Lead Joints				at
	Leadite Joints	at	\$		
6	Hrs. Foreman	at	5 2/2	\$ 3.75	
3 1/2	Hrs. Common Labor	at	50	\$ 1.75	
1 1/2	Hrs. Common Labor	at	45	\$ 5.40	
	Hrs. Mason	at		\$	
	Hrs. Mason's Helper	at		\$	
	Hrs. Compressor	at		\$	
	Compensation Ins			\$ 4	
	Trucking			\$ 1-	
	Builders Use of Water			\$	

Total \$ 20.9

1935-198

Labor and Material Report *Oct 23* 1935

Vacant lot ~~83~~ ⁸⁷ Grant Ave

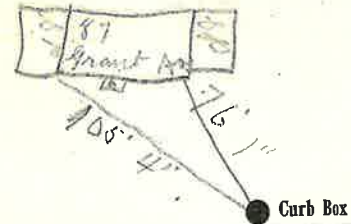

6" Main

Elev. of Main at tap 4 1/2

Gate at ●

● Gate at

● Curb Box

Lat Top
THB