


LABOR AND MATERIALS

1 Copper } Connection 3/4 \$ _____
 Lead }
 1 Curb } Cock } 3/4 in. \$ _____
 Valve }
 T.S. & V. }
 1 Service box } Short 3-1/2 x 4-1/2 } \$ _____
 Old returned } Long 4-1/2 x 5-1/2 }
24 Ft. 3/4 in. } Copper } Pipe at \$ _____
 } S. }
 } C. }
 _____ Nipples _____ in. at \$ _____
 _____ Bushings _____ to _____ in. at \$ _____
 _____ Red'g _____
 _____ Inc'g _____
 _____ Union _____ in. at \$ _____
 _____ Meter _____ in. at \$ _____
 _____ Compound Joints at \$ _____
 _____ Maintenance Foreman \$ _____
 _____ Hrs. Water Maint. Man - 1 at \$ _____
 _____ Hrs. Water Maint. Man - 2 at \$ _____
 _____ Hrs. Garage Foreman _____ at \$ _____
 _____ Hrs. Labor _____ at \$ _____
 _____ Hrs. Compressor at \$ _____
 _____ Trucking \$ _____
 _____ Pav't Patch \$ _____
 _____ \$ _____
 _____ \$ _____
St. _____
 Pt. _____
 Ave. No. 12-14
 Name of Owner GRANT

Labor and Mat'l. Report 19 30 Sept. 14

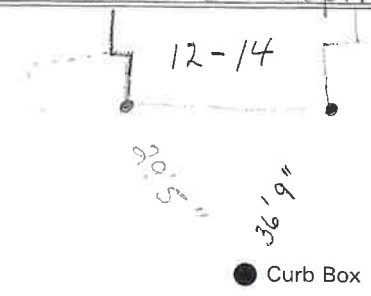

4 Main Elev. of Main at tap 5
 Gate at ● Gate at ●

● Curb Box

OLD SHUT OFF AT MAIN