


LABOR AND MATERIALS

1	Copper } Connection <u>3/4"</u>	\$
	Lead }	
1	Curb } Cock } <u>3/4</u> in.	\$
	Valve }	
	T.S. & V. }	
1	Service box { Short <u>3-1/2 x 4-1/2</u> }	\$
	Old returned { Long <u>4-1/2 x 5-1/2</u> }	
10	Ft. <u>3/4</u> in. { Copper } Pipe at	\$
	Nipples _____ in. at	\$
	Bushings _____ to _____ in. at	\$
	Red'g _____	
	Inc'g _____	
	Union _____ in. at	\$
	Meter _____ in. at	\$
	_____	\$
	Compound Joints at _____	\$
	Maintenance Foreman _____	\$
	Hrs. Water Maint. Man - 1 at _____	\$
	Hrs. Water Maint. Man - 2 at _____	\$
	Hrs. Garage Foreman _____ at _____	\$
	Hrs. Labor _____ at _____	\$
	Hrs. Compressor at _____	\$
	_____	\$
	Trucking _____	\$
	Pav't Patch _____	\$
	_____	\$
	_____	\$
GRANT Ave. No. 88

Name of Owner VACANT LOT

Labor and Mat'l. Report 1935, Oct. 23

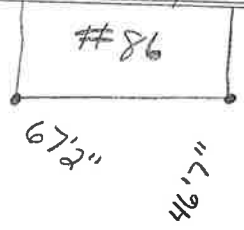

● Curb Box

6" Main Elev. of Main at tap 4 1/2

Gate at ● Gate at ●

● Curb Box

TIES FROM HOUSE #86