

LABOR AND MATERIALS

Copper	} Connection	_____	\$ _____	
Lead				
Curb	} Cock } Valve } T. S. & V.	_____ in.	\$ _____	
Service box		} Short 3½ x 4½ } Long 4½ x 5½ } Buff or Rdway	_____	\$ _____
Old returned				
8 Ft. ¾ in.	} Copper } G. I. } C.I.	Pipe at _____	\$ _____	
Nipples _____ in. at _____			\$ _____	
Bushings _____ to _____ in. at _____		\$ _____		
Red'g } Inc'g }	} Coupl'gs _____ to _____ in. at _____	\$ _____		
Union _____ in. at _____		\$ _____		
Meter _____ in. at _____	\$ _____			
Lead Joints at _____	\$ _____			
Compound Joints at _____	\$ _____			
Maintenance Foreman _____	\$ _____			
Hrs. Water Maint. Man—1 at _____	\$ _____			
Hrs. Water Maint. Man—2 at _____	\$ _____			
Hrs. Garage Foreman _____ at _____	\$ _____			
Hrs. Labor— _____ at _____	\$ _____			
Hrs. Compressor at _____	\$ _____			
Compensation Ins. at \$ _____ per C _____	\$ _____			
Trucking _____	\$ _____			
Pav't Patch _____	\$ _____			
_____	\$ _____			
_____	\$ _____			
_____	\$ _____			
O'head _____	\$ _____			
_____	\$ _____			


St. _____
Pl. _____
Ave. No. 90

GRANT

Name of Owner _____

Labor and Mat'l. Report

19

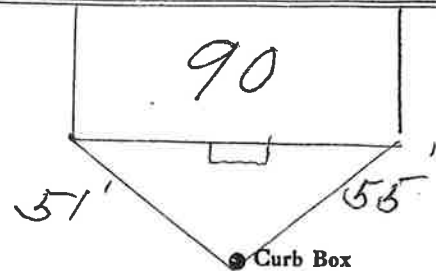

Main	Elev. of Main at tap _____
Gate at ●	● Gate at

● Curb Box