


LABOR AND MATERIALS

1	Copper	Connection	3/4"	\$	_____
1	Lead	Cock		\$	_____
1	Curb	Valve	3/4 in.	\$	_____
		T.S. & V.		\$	_____
1	Service box	Short 3-1/2 x 4-1/2		\$	_____
	Old returned	Long 4-1/2 x 6-1/2		\$	_____
28	Ft.	3/4 in.	Copper	Pipe at	\$ _____
			Est.		\$ _____
			Est.		\$ _____
	Nipples	_____ in.	at	_____	\$ _____
	Bushings	_____ to _____ in.	at	_____	\$ _____
	Red'g				\$ _____
	Inc'g				\$ _____
	Union	_____ in.	at	_____	\$ _____
	Meter	_____ in.	at	_____	\$ _____
					\$ _____
	Compound Joints at				\$ _____
	Maintenance Foreman				\$ _____
	Hrs. Water Maint. Man - 1	at			\$ _____
	Hrs. Water Maint. Man - 2	at			\$ _____
	Hrs. Garage Foreman	at			\$ _____
	Hrs. Labor	at			\$ _____
	Hrs. Compressor at				\$ _____
					\$ _____
	Trucking				\$ _____
	Pav't Patch				\$ _____
					\$ _____
					\$ _____
					\$ _____
					\$ _____

GRANT St. Ave. No. 91
 Name of Owner

Labor and Mat'l. Report 19 35, Oct. 24
 VACANT

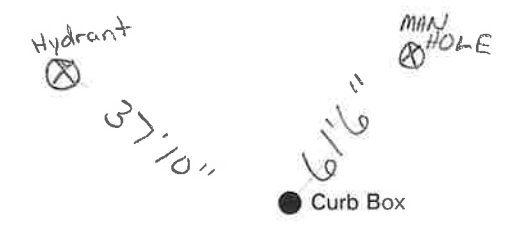

6" Main Elev. of Main at tap 4'
 Gate at ● Gate at ●

● Curb Box

LOT TAP

CLEANOUT LOCATED
 AT CURB BOX 11-5-13