

Labor and Materials


1	Copper	Connection	3/4	\$ 1.75
1	Curb	Cock Valve T.S. & V.	3/4 in	\$ 1.70
1	Service Box	Short 3 1/2 x 4 1/2		\$ 1.37
	Old returned	Long 4 1/2 x 5 1/2		
		Buff. or Blower		
22	Ft. 3/4 in.	Copper Galv. Iron Cast Iron	Pipe at 13 1/2	\$ 3.78
	Nipples	in. at		\$
	Bushings	to in. at		\$
	Red'g Inc'g	Couplings	to in. at	\$
	Union	in. at		\$
	Meter	in. at		\$
	Lbs. Br. Stone	at		\$
	Lbs. Sand	at		\$
	Bags Cement	at		\$
	Paving Brick	Mack Red Asphalt	at	\$
	Lead Joints	at		\$
	Leadite Joints	at		\$
6	Hrs. Foreman	at	6 2/3	\$ 3.75
3 1/2	Hrs. Common Labor	at	50	\$ 1.75
12	Hrs. Common Labor	at	45	\$ 5.40
	Hrs. Mason	at		\$
	Hrs. Masons Helper	at		\$
	Hrs. Compressor	at		\$
	Compensation Ins			\$ 41
	Trucking			\$ 1.00
	Builders Use of Water			\$

Total \$20.91

1935-FL 6 93 GRANT

Labor and Material Report Oct 25 1935

VACANT LOT TAP

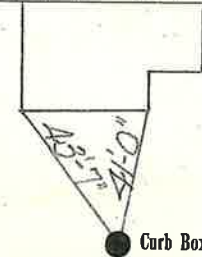

Curb Box

6" Main

Elev of Main at tap 4 ft

Gate at ●

● Gate at

● Curb Box

Tap Tap

THB