

LABOR AND MATERIALS

_____	Copper	} Connection _____	\$ _____	
_____	Lead			
_____	Curb	} Cock Valve } _____ in. _____	\$ _____	
_____				} T.S. & V. }


_____	Old returned { Long 4-1/2 x 5-1/2 } _____ \$ _____			
_____	Ft. _____ in.	{ Copper G.I. C.I. }	Pipe at _____ \$ _____	
_____	Nipples _____	in. at _____	\$ _____	
_____	Bushings _____	to _____ in. at _____	\$ _____	
_____	Red'g _____			
_____	Inc'g _____			
_____	Union _____	in. at _____	\$ _____	
_____	Meter _____	in. at _____	\$ _____	
_____			\$ _____	
_____	Compound Joints at _____		\$ _____	
_____	Maintenance Foreman _____		\$ _____	
_____	Hrs. Water Maint. Man - 1 at _____		\$ _____	
_____	Hrs. Water Maint. Man - 2 at _____		\$ _____	
_____	Hrs. Garage Foreman _____	at _____	\$ _____	
_____	Hrs. Labor _____	at _____	\$ _____	
_____	Hrs. Compressor at _____		\$ _____	
_____			\$ _____	
_____	Trucking _____		\$ _____	
_____	Pav't Patch _____		\$ _____	
_____			\$ _____	
_____			\$ _____	
GRANT

Ave. No. 97

Name of Owner _____

Labor and Mat'l. Report 1939, AUG. 22

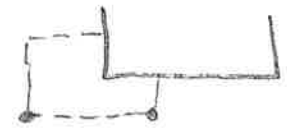

32'8" 26'10"

● Curb Box

_____ Main Elev. of Main at tap _____

Gate at ● Gate at ●

● Curb Box