

# LABOR AND MATERIALS


1	Copper } Connection	$\frac{3}{4}$ "	\$	_____
1	Curb } Cock Valve } T.S. & V. }	$\frac{3}{4}$ " in.	\$	_____
1	Service box } <del>Short 3-1/2 x 4-1/2</del> } <del>Old returned</del> } Long 4-1/2 x 5-1/2 }		\$	_____
28	Ft. $\frac{3}{4}$ in. } Copper } <del>Cast</del> }		\$	_____
	Nipples	_____ in. at _____	\$	_____
	Bushings	_____ to _____ in. at _____	\$	_____
	Red'g			_____
	Inc'g			_____
	Union	_____ in. at _____	\$	_____
	Meter	_____ in. at _____	\$	_____
			\$	_____
	Compound Joints at	_____	\$	_____
	Maintenance Foreman	_____	\$	_____
	Hrs. Water Maint. Man - 1 at	_____	\$	_____
	Hrs. Water Maint. Man - 2 at	_____	\$	_____
	Hrs. Garage Foreman	_____ at _____	\$	_____
	Hrs. Labor	_____ at _____	\$	_____
	Hrs. Compressor at	_____	\$	_____
			\$	_____
	Trucking	_____	\$	_____
	Pav't Patch	_____	\$	_____
			\$	_____
			\$	_____
			\$	_____
			\$	_____

GRANT

Ave. No. 103

Name of Owner \_\_\_\_\_

Labor and Mat'l. Report 19 35, OCT. 26

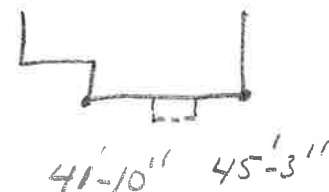

● Curb Box

6" Main

Elev. of Main at tap 4'

Gate at ●

● Gate at

● Curb Box