

## LABOR AND MATERIALS

Copper	}	Connection			\$	
Lead						
Curb	}	T. S. & V.	in.		\$	
				Cock Valve		
Service Box	}	Buff. or Rdway			\$	
Old returned				Short 3 1/2 x 4 1/2		
				Long 4 1/2 x 5 1/2		
Ft. _____ in.	}	Pipe at			\$	
			Copper			
			Galv Iron			
			Cast Iron			
Nipples _____ in.		at			\$	
Bushings _____ to _____ in.		at			\$	
Red'g } Inc'g }	}	Couplings	to _____ in.	at	\$	
Union _____ in.		at			\$	
Meter _____ in.		at			\$	
Lead Joints		at			\$	
Leadite Joints		at			\$	
Hrs. Foreman		at			\$	
Hrs. Chauffeur		at			\$	
Hrs. Tapper		at			\$	
Hrs. Labor		at			\$	
Hrs. Labor		at			\$	
Hrs. Compressor		at			\$	
Compensation 'Ins.					\$	
Trucking					\$	
Builders Use of Water					\$	
					\$	
					\$	
					\$	
					\$	

St:

Ph

Grant


Ave. No. 107

Name of Owner

TAX ID # 302.19-7-10

Labor and Mat'l. Report

AUG. 22 1939

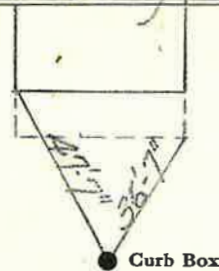

Main

Elev. of

Main at tap

Gate at ●

● Gate at

● Curb Box