


LABOR AND MATERIALS

1 Copper } Connection 3/4" \$ _____
 Lead }
 1 Curb } Cock } 3/4" in. \$ _____
 } Valve }
 } I.S. & V. }
 1 Service box { Short 3-1/2 x 4-1/2 } \$ _____
 Old returned { Long 4-1/2 x 5-1/2 }
10 Ft. 3/4 in. { Copper } Pipe at \$ _____
 } S.I. }
 } C.I. }
 _____ Nipples _____ in. at \$ _____
 _____ Bushings _____ to _____ in. at \$ _____
 _____ Red'g _____
 _____ Inc'g _____
 _____ Union _____ in. at \$ _____
 _____ Meter _____ in. at \$ _____
 _____ \$ _____
 _____ Compound Joints at \$ _____
 _____ Maintenance Foreman \$ _____
 _____ Hrs. Water Maint. Man - 1 at \$ _____
 _____ Hrs. Water Maint. Man - 2 at \$ _____
 _____ Hrs. Garage Foreman _____ at \$ _____
 _____ Hrs. Labor _____ at \$ _____
 _____ Hrs. Compressor at \$ _____
 _____ \$ _____
 _____ Trucking _____ \$ _____
 _____ Pav't Patch _____ \$ _____
 _____ \$ _____
 _____ \$ _____
GRANT St. _____
 Ave. No. 112
 Name of Owner
* VACANT LOT #

Labor and Mat'l. Report 1935. Oct. 29

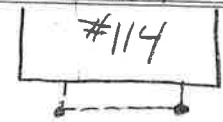

48'4" 69'10"

● Curb Box

6" Main

Elev. of Main at tap 4 1/2'

Gate at ● ● Gate at

● Curb Box

LOT TAP

MEASUREMENT FROM #114