


LABOR AND MATERIALS

1 Copper } Connection 3/4 \$ _____
 1 Lead }
 1 Curb } Cock Valve } 3/4 in. \$ _____
 } T.S. & V.
 1 Service box { Short 3-1/2 x 4-1/2 } \$ _____
 Old returned { Long 4-1/2 x 6-1/2 }
10 Ft. 3/4 in. { Copper } Pipe at \$ _____
 }
 _____ Nipples _____ in. at \$ _____
 _____ Bushings _____ to _____ in. at \$ _____
 _____ Red'g _____
 _____ Inc'g _____
 _____ Union _____ in. at \$ _____
 _____ Meter _____ in. at \$ _____
 _____ Compound Joints at \$ _____
 _____ Maintenance Foreman \$ _____
 _____ Hrs. Water Maint. Man - 1 at \$ _____
 _____ Hrs. Water Maint. Man - 2 at \$ _____
 _____ Hrs. Garage Foreman _____ at \$ _____
 _____ Hrs. Labor _____ at \$ _____
 _____ Hrs. Compressor at \$ _____
 _____ Trucking \$ _____
 _____ Pav't Patch \$ _____
 _____ \$ _____
 _____ \$ _____
 _____ \$ _____
 _____ \$ _____

-St. _____
 -Pt. _____
 Ave. No. 13
GRANT
 Name of Owner _____

Labor and Mat'l. Report 19 31, Aug. 5

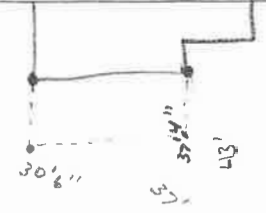

● Curb Box

4 Main Elev. of Main at tap 5

Gate at ● ● Gate at

10' 3/4 copper

● Curb Box

OLD TAP DISCONNECTED

TAX ID # 302.15-14-25