

LABOR AND MATERIALS


Copper	Cock	Connection			\$
Lead	Valve		in.		\$
1	T. S. & V.				\$
1	Service Box	Short 3 1/2 x 4 1/2			\$
	Old returned	Long 4 1/2 x 5 1/2			\$
		Buff. on Rdway			\$
3	Ft. 1/4 in.	Copper	Pipe at		\$
		Galv Iron			\$
		Cast Iron			\$
	Nipples	in. at			\$
	Bushings	to in. at			\$
	Red'g	Couplings	to in. at		\$
	Inc'g				\$
	Union	in. at			\$
	Meter	in. at			\$
	Lead Joints	at			\$
	Leadite Joints	at			\$
	Hrs. Foreman	at			\$
	Hrs. Chauffeur	at			\$
	Hrs. Tapper	at			\$
	Hrs. Labor	at			\$
	Hrs. Labor	at			\$
	Hrs. Compressor	at			\$
	Compensation Ins.				\$
	Trucking				\$
	Builders Use of Water				\$
					\$
					\$
					\$
					\$

ct

St.
Pt.
Ave. No. 115

Name of Owner _____

Labor and Mat'l. Report Aug. 22 1927

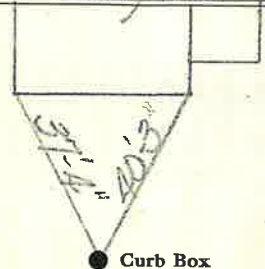

Main Elev. of Main at tap

Gate at ● ● Gate at

To shut off ● Curb Box
Be show. This
stop is straight
across