


### LABOR AND MATERIALS

|                               |     |    |
|-------------------------------|-----|----|
| Copper } Connection           | \$  |    |
| Lead } Connection             | \$  |    |
| Curb } Cock                   | in. | \$ |
| } Valve                       |     |    |
| } T. S. & V.                  |     |    |
| Service box { Short 3½ x 4½   |     |    |
| Old returned { Long 4½ x 5½   |     |    |
| } Buff or Rdway               | \$  |    |
| 78 Ft. 1 in. { Copper         |     |    |
| } S.I.                        | \$  |    |
| } S.I.                        |     |    |
| } Pipe at                     | \$  |    |
| Nipples in. at                | \$  |    |
| Bushings to in. at            | \$  |    |
| Red'g } Coupl'gs. to in. at   | \$  |    |
| Inc'g }                       |     |    |
| Union in. at                  | \$  |    |
| Meter in. at                  | \$  |    |
| Lead Joints at                | \$  |    |
| Compound Joints at            | \$  |    |
| Maintenance Foreman           | \$  |    |
| Hrs. Water Maint. Man—1 at    | \$  |    |
| Hrs. Water Maint. Man—2 at    | \$  |    |
| Hrs. Garage Foreman at        | \$  |    |
| Hrs. Labor— at                | \$  |    |
| Hrs. Compressor at            | \$  |    |
| Compensation Ins. at \$ per C | \$  |    |
| Trucking                      | \$  |    |
| Pav't Patch                   | \$  |    |
|                               | \$  |    |
|                               | \$  |    |
|                               | \$  |    |
|                               | \$  |    |
| O'head                        | \$  |    |
|                               | \$  |    |

St. Graves  
~~Pl.~~  
 Ave. No. 14

Name of Owner \_\_\_\_\_

Labor and Mat'l. Report 6-21 1985

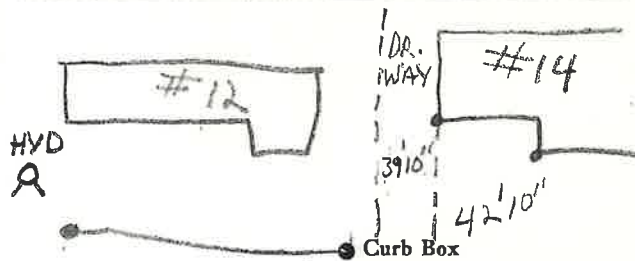

6" Main                      Elev. of Main at tap 4½'

Gate at ●                      ● Gate at

● Curb Box