


LABOR AND MATERIALS

Copper	} Connection	_____	\$ _____			
Lead						
Curb	} Cook Valve T. S. & V.	} _____ in.	\$ _____			
				} Service box	} Short 3½ x 4½	\$ _____
		Buff or Rdway	\$ _____			
Ft.	} _____ in.	} Copper G. I. C. I.	} Pipe at _____	\$ _____		
					Nipples _____ in. at _____	\$ _____
					Bushings _____ to _____ in. at _____	\$ _____
Red'g } Inc'g }	} Coupl'gs _____ to _____ in. at _____	\$ _____	\$ _____			
Union _____ in. at _____						
Meter _____ in. at _____	\$ _____					
Lead Joints at _____	\$ _____					
Compound Joints at _____	\$ _____					
Maintenance Foreman _____	\$ _____					
Hrs. Water Maint. Man-1 at _____	\$ _____					
Hrs. Water Maint. Man-2 at _____	\$ _____					
Hrs. Garage Foreman _____ at _____	\$ _____					
Hrs. Labor _____ at _____	\$ _____					
Hrs. Compressor at _____	\$ _____					
Compensation Ins. at \$ _____ per C	\$ _____					
Trucking _____	\$ _____					
Pav't Patch _____	\$ _____					
_____	\$ _____					
_____	\$ _____					
_____	\$ _____					
O'head _____	\$ _____					

St. _____
~~Pl.~~ _____
 Ave. No. 24

Name of Owner _____
Mrs. Lyford

Labor and Mat'l. Report _____ 19 86

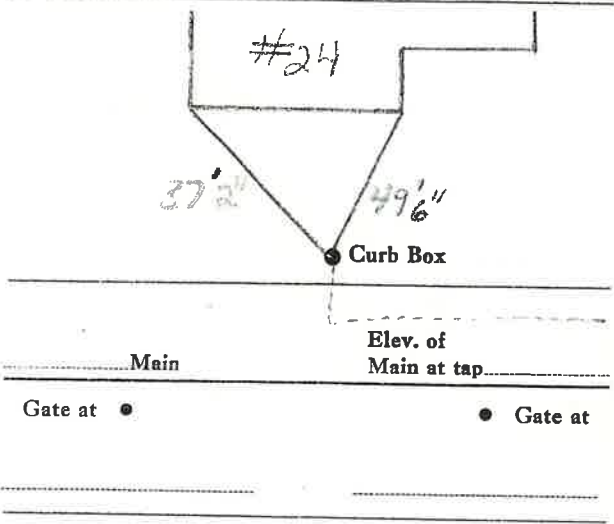

● Curb Box

TAPPED ON LEXINGTON IN
FRONT OF #60