

LABOR AND MATERIALS

1" x 1" x 3/4" BRASS TEE

1 } Copper } Connection 1 - 3/4 MALE \$ _____
 Lead }
 1 } Curb } Cock } 3/4 in. \$ ORISEAL
 Valve } ADAPTER }
 I.O. & V. }

1 } Service box } { Short 2-1/2 x 4-1/2 } \$ _____
 Old returned } { Long 4-1/2 x 5-1/2 } \$ _____

6 Ft. 3/4 in. { Copper } Pipe at \$ _____
 Gal. }

_____ Nipples _____ in. at \$ _____

_____ Bushings _____ to _____ in. at \$ _____

_____ Red'g _____

_____ Inc'g _____

_____ Union _____ in. at \$ _____

_____ Meter _____ in. at \$ _____

_____ \$ _____

_____ Compound Joints at \$ _____

_____ Maintenance Foreman \$ _____

_____ Hrs. Water Maint. Man - 1 at \$ _____

_____ Hrs. Water Maint. Man - 2 at \$ _____

_____ Hrs. Garage Foreman _____ at \$ _____

_____ Hrs. Labor _____ at \$ _____

_____ Hrs. Compressor at \$ _____

_____ \$ _____

_____ Trucking \$ _____

_____ Pav't Patch \$ _____

_____ \$ _____

_____ \$ _____

_____ \$ _____


_____ \$ _____

_____ \$ _____

GRAVES St. No. 26

Name of Owner LEO JACOBS

Labor and Mat'l. Report 19 65, DEC. 3

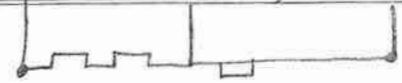

59' 8" 35' 10"

● Curb Box

1" COPPER Main Elev. of Main at tap 5'

Gate at ● Gate at ●

TAX ID # 302.12-13-12

● Curb Box