

LABOR AND MATERIALS


1	Copper Lead	Connection	1"	\$
1	Curb	Cock Valve T.S. & V.	1 in. <i>Oriseal</i>	\$
1	Service box Old returned	Short 3 1/2 x 4 1/2 Long 4 1/2 x 5 1/2 Buff or Rdway		\$
2	Ft. 1 in.	Copper C.I. C.I.	Pipe at	\$
	Nipples	in. at		\$
	Bushings	to in. at		\$
	Red'g Inc'g	Coupl'gs to in. at		\$
1	Union	1 in. at	<i>Male Adapter</i>	\$
	Meter	in. at	<i>Cap to 11'00'</i>	\$
	Lead Joints at			\$
	Compound Joints at			\$
	Maintenance Foreman			\$
	Hrs. Water Maint. Man-1 at			\$
	Hrs. Water Maint. Man-2 at			\$
	Hrs. Garage Foreman at			\$
	Hrs. Labor at			\$
	Hrs. Compressor at			\$
	Compensation Ins. at \$	per C		\$
	Trucking			\$
	Pav't Patch			\$
	<i>Tap by Larreau &amp; Co</i>			\$
	<i>12-8-65.</i>			\$
	O'head			\$

Measurements for 1" Shutoff for 1" Copper Main on Graves

St. PI. Ave. No.

Name of Owner  
*Lexington Ave. End,*

Labor and Mat'l. Report *Dec. 8* 1965.

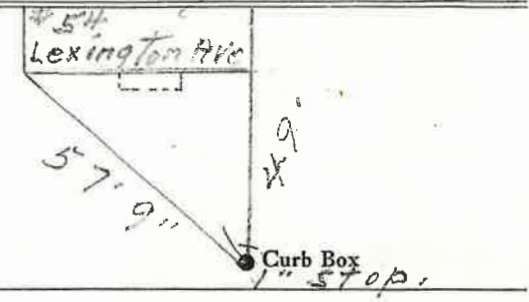

6" Main Elev. of Main at tap 4'

Gate at • • Gate at

• Curb Box

*This Tap measured from 54 Lexington Ave*

Measurement for 1" shutoff for 1" copper main on Graves  
This tap measured from 54 Lexington Ave


Extending 1" Main on  
 Graves St.  
 3-Coils of 66' Length 1" Copper Pipe  
 1-55" Piece

2-1" x 3/4" Brass TEES

3-1" Couplings

4 adapters

used.  
 1-Short  
 bolt + Nut.  
 1-1/2" curb  
 stop  
 used

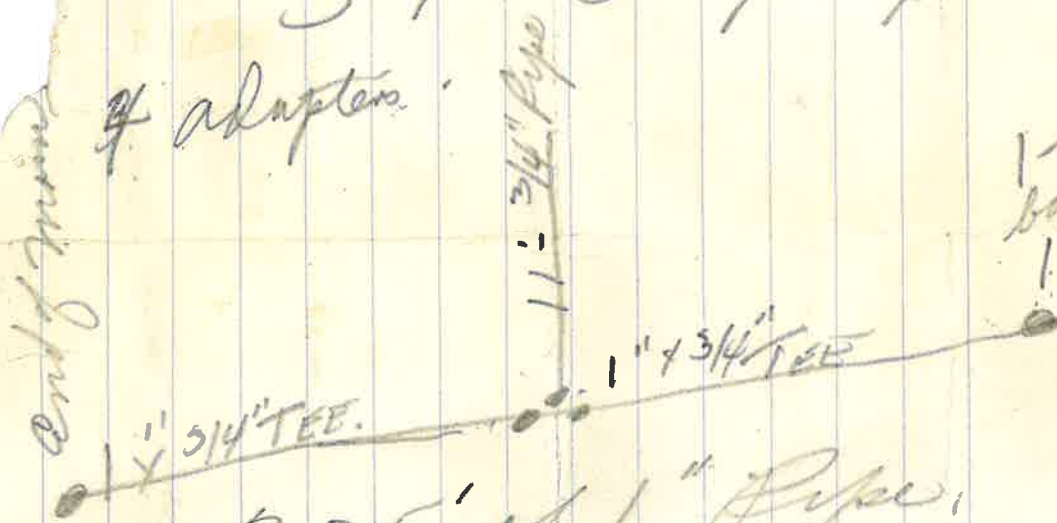

235' of 1" Pipe  
 + 218'  
 -----  
 453' To END of MAIN

218  
 235  
 -----  
 453