

LABOR AND MATERIALS

1	Copper Lead	Connection	3/4"	\$ 2.60
1	Curb	Cock Valve T.S. & V.	3/4" in.	\$ 2.30
new	Service box	Short 3 1/2 x 4 1/2		
	Old returned	Long 4 1/2 x 5 1/2		\$
22 FT				
3	Ft. 3/4" in.	Copper Pipe at		\$ 2.22
	Nipples	in. at		\$
	Bushings	to in. at		\$
	Red'g			
	Inc'g	Coupl'gs to in. at		\$
	Union	in. at		\$
	Meter	in. at		\$
				\$
	Compound Joints	at		\$
5	Maintenance Foreman		3.13	\$
	Hrs. Water Maint. Man-1	at		\$
	Hrs. Water Maint. Man-2	at		\$
	Hrs. Garage Foreman	at		\$
10	Hrs. Labor	at	4.06	\$
	Hrs. Compressor	at		\$
				\$
	Trucking		1.00	\$
	Pav't Patch			\$
				\$
				\$
CURB BOX EXTENDED  
OUT OF DRIVEWAY TO GRASS  
WILLIAMS & CO  
ALL

29-46


St. Pl. Ave. No. 5-7

Name of Owner

5-7 GROVE

Labor and Mat'l. Report

1929

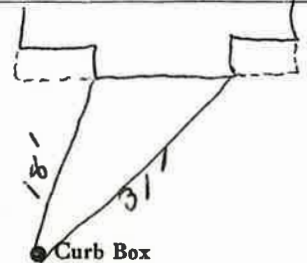

6" Main

Elev. of Main at tap 4 1/2 FT

Gate at ●

● Gate at

● Curb Box

OLD TAP SHUT OFF

#5 TAX ID # 302.20-2-19

**Labor and Materials**


1	Copper } Connection <i>3/4"</i>	\$ 2.60
	Lead } .....	
1	Curb } Cock Valve } <i>3/4"</i> in.	\$ 2.30
	} T & S & V. } .....	
1	Service Box } Short <i>3 1/2 x 4 1/2</i>	\$ 1.40
	Old returned } Long <i>4 1/2 x 5 1/2</i>	
	} Buff. or Rdway } .....	
8	Ft. <i>3/4"</i> in. } Copper Galv. Iron } Pipe at.	\$ 2.12
	} Cast Iron } .....	
	Nipples..... in. at.....	\$
	Bushings..... to..... in. at.....	\$
	Red'g } Couplings..... to..... in. at.....	\$
	Inc'g } .....	
	Union..... in. at.....	\$
	Meter..... in. at.....	\$
	Lbs. Br. Stone at.....	\$
	Lbs. Sand at.....	\$
	Bags Cement at.....	\$
	Paving Brick } Mack } at.....	\$
	} Red } .....	
	} Asphalt } .....	
	Lead Joints at.....	\$
	Leadite Joints at.....	\$
5	Hrs. Foreman at.....	\$ 3.13
10	Hrs. Common Labor at.....	\$ 4.06
	Hrs. Common Labor at.....	\$
	Hrs. Mason at.....	\$
	Hrs. Mason's Helper at.....	\$
	Hrs. Compressor at.....	\$
	Compensation Ins.....	\$ 1.19
	Trucking.....	\$ 1.00
	Builders' Use of Water <i>Patch</i>	\$ 25.00

Total \$41.80

29-46  
Labor and Material Report

1927

*May 16*  
*5-7 Grove Ave*

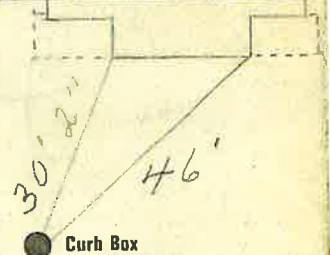

*6* Main

Elev of Main at tap *alt*

Gate at ●

● Gate at

● Curb Box

*Old tap shut off*