


# LABOR AND MATERIALS

<u>1</u>	Copper } Connection	<u>3/4</u>	\$	_____
<u>1</u>	Curb } Cock	<u>3/4</u> in.	\$	_____
<u>1</u>	Service box } <del>Short</del> <u>3-1/2 x 4-1/2</u>		\$	_____
	Old returned } <u>Long 4-1/2 x 5-1/2</u>		\$	_____
<u>24</u>	Ft. } <u>3/4</u> in. } <u>Copper</u>		\$	_____
	Nipples	_____ in. at _____	\$	_____
	Bushings	_____ to _____ in. at _____	\$	_____
	Red'g		\$	_____
	Inc'g		\$	_____
	Union	_____ in. at _____	\$	_____
	Meter	_____ in. at _____	\$	_____
	Compound Joints at _____		\$	_____
	Maintenance Foreman _____		\$	_____
	Hrs. Water Maint. Man - 1 at _____		\$	_____
	Hrs. Water Maint. Man - 2 at _____		\$	_____
	Hrs. Garage Foreman _____ at _____		\$	_____
	Hrs. Labor _____ at _____		\$	_____
	Hrs. Compressor at _____		\$	_____
	Trucking _____		\$	_____
	Pav't Patch _____		\$	_____
			\$	_____
			\$	_____
St. GROVE  
 Ave. No. 18  
 Name of Owner \_\_\_\_\_

Labor and Mat'l. Report 19 86

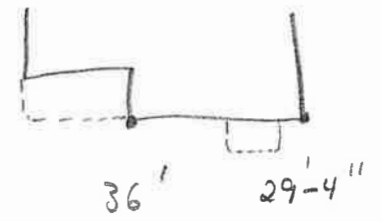

● Curb Box  
 6" Main  
 Elev. of Main at tap 5'  
 Gate at ● Gate at ●

TAX ID #302.20-4-6

● Curb Box