

LABOR AND MATERIALS


1 Copper } Connection 3/4 \$ _____
~~Lead~~
 1 Curb } Cock } 3/4 in. \$ _____
 } Valve }
 } T.G. & V. }
 1 Service box { Short 3-1/2 x 4-1/2 } \$ _____
 Old returned { ~~Long 4-1/2 x 5-1/2~~ }
 11 Ft. 3/4 in. { Copper } Pipe at \$ _____
 } ~~Gal.~~ }
 _____ Nipples _____ in. at \$ _____
 _____ Bushings _____ to _____ in. at \$ _____
 _____ Red'g _____
 _____ Inc'g _____
 _____ Union _____ in. at \$ _____
 _____ Meter _____ in. at \$ _____
 _____ \$ _____
 _____ Compound Joints at \$ _____
 _____ Maintenance Foreman \$ _____
 _____ Hrs. Water Maint. Man - 1 at \$ _____
 _____ Hrs. Water Maint. Man - 2 at \$ _____
 _____ Hrs. Garage Foreman _____ at \$ _____
 _____ Hrs. Labor _____ at \$ _____
 _____ Hrs. Compressor at \$ _____
 _____ \$ _____
 _____ Trucking \$ _____
 _____ Pav't Patch \$ _____
 _____ \$ _____
 _____ \$ _____
GROVE

Ave. No. 21

Name of Owner _____

Labor and Mat'l. Report 19 35, AUG 27

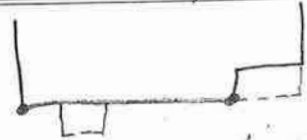

34' 8" 28' 3"

● Curb Box

6" Main

Elev. of Main at tap 4'

Gate at ●

● Gate at

TAX ID # 302.20-2-12

● Curb Box

OLD SHUT OFF AT MAIN