

LABOR AND MATERIALS


1 Copper ~~Lead~~ Connection 3/4" \$  
 1 Curb } Cook Valve } 3/4 in. MARKED ORIGINAL \$  
 } T.S. & V. }  
 1 Service box { Short 3 1/2 x 4 1/2 }  
 Old returned { Long 4 1/2 x 5 1/2 } \$  
 } Buff or Rdway }  
25 Ft. 3/4 in. { Copper } Pipe at \$  
 } ~~S.P.~~ }  
 } ~~S.P.~~ }  
 Nipples in. at \$  
 Bushings to in. at \$  
 Red'g }  
 Inc'g } Coupl'gs to in. at \$  
 Union in. at \$  
 Meter in. at \$  
 Lead Joints at \$  
 Compound Joints at \$  
 Maintenance Foreman \$  
 Hrs. Water Maint. Man-1 at \$  
 Hrs. Water Maint. Man-2 at \$  
 Hrs. Garage Foreman at \$  
 Hrs. Labor at \$  
 Hrs. Compressor at \$  
 Compensation Ins. at \$ per C \$  
 Trucking \$  
 Pav't Patch \$  
 \$  
TAP MADE BY PECK & S \$  
 \$  
 O'head MAY-11-1922 \$  
 \$

GROVE

St. ~~St.~~  
 Ave. No. 24

Name of Owner  
George Bell

Labor and Mat'l. Report MAY 11 1922

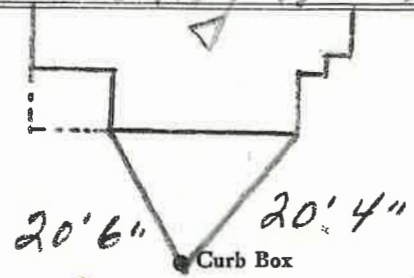

6" Main

Elev. of Main at tap 5'

Gate at ● ● Gate at

TAX ID # 302.20-4-9

● Curb Box