

LABOR AND MATERIALS

Copper	}	Connection	\$			
Lead						
Curb	}	Cock	} in.	\$		
		Valve				
		T. S. & V.				
Service box	}	Short 3½ x 4½	} \$			
Old returned		Long 4½ x 5½				
		Buff or Rdway				
Ft. ¾ in.	}	Copper	} Pipe at	\$		
		Galv.				
		Galv.				
Nipples	in.	at	\$			
Bushings	to	in.	at	\$		
Red'g	}	Coupl'gs	to	in.	at	\$
Inc'g						
Union	in.	at	\$			
Meter	in.	at	\$			
Lead Joints	at		\$			
Compound Joints	at		\$			
Maintenance Foreman			\$			
Hrs. Water Maint. Man-1	at		\$			
Hrs. Water Maint. Man-2	at		\$			
Hrs. Garage Foreman	at		\$			
Hrs. Labor	at		\$			
Hrs. Compressor	at		\$			
Compensation Ins.	at \$	per C	\$			
Trucking			\$			
Pav't Patch			\$			
			\$			
			\$			
O'head			\$			
			\$			


GROVE

St.
Pt. Ave. No. 9

Name of Owner

Labor and Mat'l. Report

JULY 2 1982

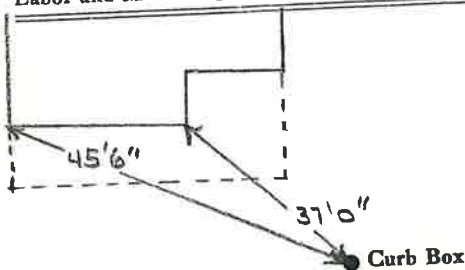

6" Main

Elev. of Main at tap 5 ½'

Gate at ●

● Gate at

renewed tap

● Curb Box