


Labor and Materials

1	Copper	Connection	3/4	\$	2.70
1	Curb	Cock Valve	3/4	\$	2.39
1	Service Box	Short 3/4x1/2		\$	1.45
	Old returned	Long 1/2x3/4		\$	
		Buff. or Redway		\$	
10	Ft.	Copper	3	\$	2.70
		Cast Iron	4	\$	
	Nipples	in. at		\$	
	Bushings	to in. at		\$	
	Red'g Inc'g	Couplings to in. at		\$	
	Union	in. at		\$	
	Meter	in. at		\$	
	Lbs. Br. Stone	at		\$	
	Lbs. Sand	at		\$	
	Bags Cement	at		\$	
	Paving Brick	Mack Red Asphalt at		\$	
	Lead Joints	at		\$	
	Leadite Joints	at		\$	
6	Hrs.	Foreman at		\$	9.75
7	Hrs.	Common Labor at		\$	3.15
	Hrs.	Common Labor at		\$	
	Hrs.	Mason at		\$	
	Hrs.	Mason's Helper at		\$	
1	Hrs.	Compressor at		\$	1.50
	Compensation Ins			\$.24
	Trucking			\$	1.00
	Builders' Use of Water	Patch		\$.75
Total \$					43.89

30-140 29-31 GROW
 Labor and Material Report Oct 24-19 20

31' Grow area

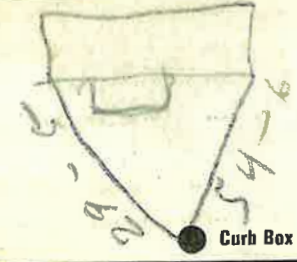

Main Elev of Main at tap
 Gate at Gate at
 TAX ID # 302.19-20-17

● Curb Box
Old tap disc

10-4-2011
 OUTSIDE CLEANOUT INSTALLED
 BEHIND RIGHT SIDE DRIVEWAY
 3' FROM VENT