

Labor and Materials


Copper	} Connection.....	3	\$ 1.33
Lead			
Curb	} Cock Valve	3	\$ 1.58
Service Box	} Short 3 1/2 x 4 1/2		
Old returned		Long 4 1/2 x 6 1/2	
24 Ft.	} Copper Galv. Iron		
in.		Pipe at	\$ 2.28
Nipples	in. at		\$
Bushings	to in. at		\$
Red'g Inc'g	} Couplings.....to.....in.at		\$
Union		in. at	\$
Meter	in. at		\$
Lbs. Br. Stone	at		\$
Lbs. Sand	at		\$
Bags Cement	at		\$
Paving Brick	} Mack Red Asphalt		\$
Lead Joints		at	\$
Leadite Joints		at	\$
7 Hrs. Foreman	at		\$ 4.38
16 Hrs. Common Labor	at Tapper		\$ 6.00
19 Hrs. Common Labor	at		\$ 4.50
Hrs. Mason	at		\$
Hrs. Masons Helper	at		\$
3 Hrs. Compressor	at		\$ 2.63
Compensation Ins			\$ 43
Trucking			\$ 1
Builders Use of Water	Patch		\$ 9
Total \$			33.49

33-63

Labor and Material Report

Aug - 17 1933

32 Grove Ave

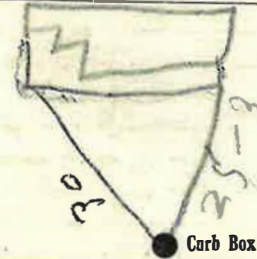

6 Main

Elev. of Main at tap 5

Gate at ●

● Gate at

● Curb Box

Old tap shut off at main

[Handwritten initials]

Old tap shut off at main