


**Labor and Materials**

1	Copper	} Connection		\$
	Lead			
	Curb	} Cock Valve T. S. & V.	in	\$
	Service Box	} Short 3 1/2 x 4 1/2 Long 4 1/2 x 5 1/2 Buff. or Rdway		\$
	Old returned			
	Ft.	} Copper Galv. Iron Cast Iron	Pipe at	\$
	in.			
	Nipples	in. at		\$
1	Bushings	to	in. at	\$
	Red'g Inc'g	} Couplings	to	in. at
	Union	in. at		\$
	Meter	in. at		\$
	Lbs. Br. Stone	at		\$
	Lbs. Sand	at		\$
	Bags Cement	at		\$
	Paving Brick	} Mack Red Asphalt	at	\$
	Lead Joints	at		\$
	Leadite Joints	at		\$
4	Hrs. Foreman	at		\$
7	Hrs. Common Labor	at	50	\$
7	Hrs. Common Labor	at		\$
	Hrs. Mason	at		\$
	Hrs. Mason's Helper	at		\$
2	Hrs. Compressor	at		\$
	Compensation Ins.			\$
	Trucking			\$
	Builders' Use of Water			\$
	<b>Total</b>	\$		

27-208

Labor and Material Report *no 34* 1927

*no 34*

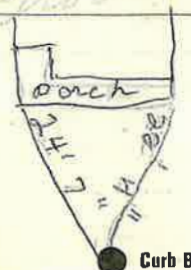

Main Elev. of Main at tap  
 Gate at ● Gate at ●  
 TAX ID # 302.20-3-10

● Curb Box

*Old Tap Sheet  
off*

*Parment*