

Labor and Materials


Copper	Connection	3/4	\$ 1.33
Lead			
Curb	Cock Valve	3/4 in	\$ 1.58
	Service Box	Short 3 1/2 x 4 1/2	\$ 1.36
	Old returned	Long 4 1/2 x 6 1/2	
		Ret. of Rdway	
25 Ft.	in.	Copper Galv. Iron Cast Iron	Pipe at 3/4" \$ 2.38
Nipples	in. at		\$
Bushings	to in. at		\$
Red'g Inc'g	Couplings	to in. at	\$
Union	in. at		\$
Meter	in. at		\$
Lbs. Br. Stone	at		\$
Lbs. Sand	at		\$
Bags Cement	at		\$
Paving Brick	Mack Red Asphalt	at	\$
Lead Joints	at		\$
Leadite Joints	at		\$ 2.12
5 Hrs.	Foreman at		\$ 6.-
12 Hrs.	Common Labor at		\$ 5.00
17 Hrs.	Common Labor at		\$
Hrs.	Mason at		\$
Hrs.	Masons Helper at		\$
Hrs.	Compressor at		\$ 20
Compensation Ins			\$ 1.-
Trucking			\$ 9.-
Builders Use of Water	Patch		\$
Total			\$ 31.38

33-53

Labor and Material Report

July 24 1933

36 Grove Ave

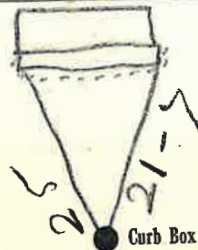

6 Main

Elev. of Main at tap 5

Gate at ●

● Gate at

TAX ID # 302.20-3-11

● Curb Box

old tarp sheet off at
Main

[Handwritten signature]

[Handwritten mark]