


### LABOR AND MATERIALS

Copper } Connection	_____	\$ _____	
Lead } _____	_____	\$ _____	
Curb } _____	} _____ in.	\$ _____	
			Cock
			Valve } T. S. & V. }
Service box	{ Short 3½ x 4½	\$ _____	
Old returned	{ Long 4½ x 5½		
	{ Buff or Rdway }		
10'8" Ft. ¾ in.	{ Copper } Pipe at	\$ _____	
	{ G. I. }		
	{ G. I. }		
Nipples _____ in. at _____		\$ _____	
Bushings _____ to _____ in. at _____		\$ _____	
Red'g } _____	} Coupl'gs _____ to _____ in. at _____	\$ _____	
Inc'g }			
Union _____ in. at _____		\$ _____	
Meter _____ in. at _____		\$ _____	
Lead Joints at _____		\$ _____	
Compound Joints at _____		\$ _____	
Maintenance Foreman _____		\$ _____	
Hrs. Water Maint. Man—1 at _____		\$ _____	
Hrs. Water Maint. Man—2 at _____		\$ _____	
Hrs. Garage Foreman _____ at _____		\$ _____	
Hrs. Labor _____ at _____		\$ _____	
Hrs. Compressor at _____		\$ _____	
Compensation Ins. at \$ _____ per C _____		\$ _____	
Trucking _____		\$ _____	
Pav't Patch _____		\$ _____	
_____		\$ _____	
_____		\$ _____	
_____		\$ _____	
O'head _____		\$ _____	
_____		\$ _____	

St. \_\_\_\_\_  
Pl. \_\_\_\_\_  
Ave. No. 37

Name of Owner  
G. Hamlin

Labor and Mat'l. Report 10-13 19 86

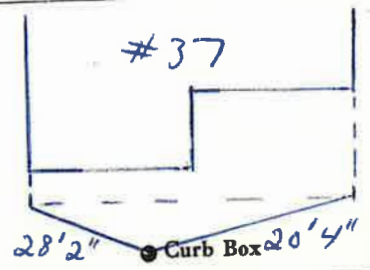

Elev. of  
Main at tap \_\_\_\_\_

Gate at • \_\_\_\_\_ • Gate at \_\_\_\_\_

TAX ID # 302.19-20-14

● Curb Box