


LABOR AND MATERIALS

1	Copper Lead	Connection	$\frac{3}{4}$ "	\$
1	Curb	Cock Valve T. S. & V.	$\frac{3}{4}$ in. oriseat.	\$
1	Service box	Short $3\frac{1}{2}$ x $4\frac{1}{2}$		
	Old returned	Long $4\frac{1}{2}$ x $5\frac{1}{2}$		
		Buff or Rdway		\$
12	Ft. $\frac{3}{4}$ in.	Copper Pipe at		\$
		G. I.		\$
		C. I.		\$
	Nipples	in. at		\$
	Bushings	to in. at		\$
	Red'g			\$
	Inc'g	Coupl'gs. to in. at		\$
	Union	in. at		\$
	Meter	in. at		\$
	Lead Joints	at		\$
	Compound Joints	at		\$
	Maintenance Foreman			\$
	Hrs. Water Maint. Man	1 at		\$
	Hrs. Water Maint. Man	2 at		\$
	Hrs. Garage Foreman	at		\$
	Hrs. Labor	at		\$
	Hrs. Compressor	at		\$
	Compensation Ins. at \$	per C		\$
	Trucking			\$
	Pav't Patch			\$
	Tap by Gifford & Co.			\$
		10-26-65		\$
	O'head			\$

Grove ~~St.~~  
~~Pl.~~  
 Ave. No. 58

Name of Owner  
 Mead

Labor and Mat'l. Report Oct. 26 19 65

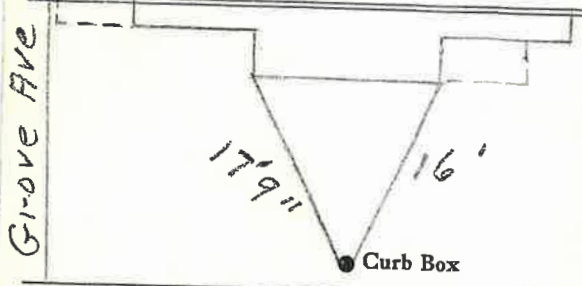

10" Main Elev. of Main at tap 6'

Gate at • • Gate at

TAX ID # 302.20-3-12

• Curb Box  
 This Tap is on  
 Crandall St.  
 Side,