


Labor and Materials

Copper } Connection <i>3/4</i>	\$ 3.20
Lead } Connection <i>3/4</i>	
Curb } Cock } <i>3/4</i> in.	\$ 1.00
} Valve } <i>3/4</i> in.	
} T.S. & V. } <i>3/4</i> in.	
Service Box } Short <i>3/4</i> x <i>1</i>	\$ 1.40
Old returned } Long <i>4 1/2</i> x <i>5 1/2</i>	
} Buff or Rdway }	
<i>10</i> Ft. <i>3/4</i> in. } Copper } Pipe at	<i>2.20</i>
} Galv. Iron } Pipe at	
} Cast Iron }	
Nipples..... in. at.....	\$
Bushings. <i>3/4</i> to <i>1/2</i> in. at.....	\$ <i>.15</i>
Red'g } Couplings..... to..... in. at.....	\$
Inc'g }	
Union..... in. at.....	\$
Meter..... in. at.....	\$
Lbs. Br. Stone at.....	\$
Lbs. Sand at.....	\$
Bags Cement at.....	\$
Paving Brick } Mack } at.....	\$
} Red }	
} Asphalt }	
Lead Joints at.....	\$
Leadite Joints at.....	\$
<i>2</i> Hrs. Foreman at..... <i>50</i>	\$ <i>1.50</i>
<i>10</i> Hrs. Common Labor at..... <i>40.6</i>	\$ <i>4.06</i>
Hrs. Common Labor at.....	\$
Hrs. Mason at.....	\$
Hrs. Mason's Helper at.....	\$
Hrs. Compressor at.....	\$
Compensation Ins.....	\$ <i>.13</i>
Trucking.....	\$ <i>1.50</i>
Builders' Use of Water.....	\$
Total \$ <i>14.14</i>	

Labor and Material Report

19 *27*

39 Spruce Ave

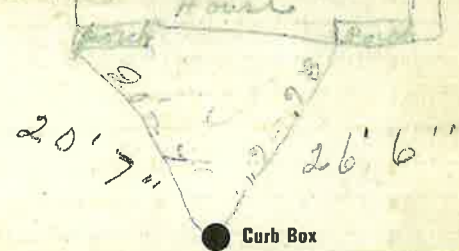

Tap on Crandell

Main Elev. of Main at tap *5'*

Gate at ● ● Gate at

● Curb Box

old tap shut off