

LABOR AND MATERIALS

1	Copper Lead	{ Connection	3/4	\$	2.87
1	Curb	{ Cock Valve T.S. & V.	3/4 in.	\$	3.62
1	Service box Old returned	{ Short 3 1/2 x 4 1/2 Long 4 1/2 x 5 1/2 Buff or Rdway		\$	4.68
26	Ft. 3/4 in.	{ Copper G.I. C.I. } Pipe at	32	\$	8.37
	Nipples	in. at		\$	
	Bushings	to in. at		\$	
	Red'g Inc'g	{ Coupl'gs to in. at		\$	
	Union	in. at		\$	
	Meter	in. at		\$	
	Lead Joints at			\$	
	Compound Joints at			\$	
	Hrs. Water Maint. Man-1 at			\$	
5	Hrs. Water Maint. Man-2 at	1.02		\$	5.10
23	Hrs. Labor	at 91		\$	20.93
	Hrs. Labor	at		\$	
2	Hrs. Compressor at	1.20		\$	2.40
	Compensation Ins. at \$ 2.18 per C.			\$	5.97
	Trucking			\$	2.02
	Pav't Patch			\$	14.85
	<i>Top 4 Mfg. Unit</i>			\$	
	O'head			\$	
				\$	65.34


124

Grave Ave

St. Pl. Ave. No. 42

Name of Owner
Geo Alexander

Labor and Mat'l. Report Nov 14 1949

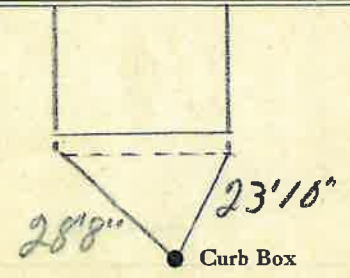

6 Main Elev. of Main at tap 5

Gate at • Gate at

TAX ID # 302.19-22-7

• Curb Box