

## LABOR AND MATERIALS

/ Copper Lead	} Connection	3/4			\$ 1.35
/ Curb	{ Cock Valve T.S. & V.	3/4 in.			\$ 1.80
/ Service Box Old returned	{ Short 3 1/2 x 4 1/2 Long 4 1/2 x 5 1/2 Buff or Rdway	Same			\$ —
10 Ft. 3/4 in.	{ Copper Galv Iron Cast Iron	Pipe at 18			\$ 1.80
Nipples	in. at				\$
Bushings	to in. at				\$
Red'g Inc'g	} Couplings	to in. at			\$
Union	in. at				\$
Meter	in. at				\$
Lead Joints at					\$
Leadite Joints at					\$
Hrs. Foreman at					\$
2 Hrs. Chauffeur at	6.24				\$ 1.25
6 Hrs. Tapper at					\$ 3.75
6 Hrs. Labor at	45				\$ 2.70
Hrs. Labor at					\$
Hrs. Compressor at					\$
Compensation Ins.					\$ 24
Trucking					\$ 1
Builders Use of Water	Patch				\$ 9
Tap by Wessel					\$
					\$
					\$
					\$ 22.89

47 1941

Grove


St.  
PL  
Ave. No. 43

Name of Owner

Parkhurst

Labor and Mat'l. Report

Apr 29 1941

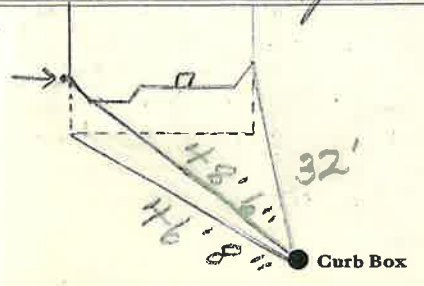

6 Main

Elev. of  
Main at tap 5 1/2

Gate at ●

● Gate at

● Curb Box

To be billed