


Labor and Materials

/	Copper } Connection..	3/4			\$
	Lead				
/	Curb { Cock } { Valve } { T. S. & V. }	3/4	in.		\$
/	Service Box } Old returned { Short 3/4 x 4 } { Long 4 1/2 x 5 } { Buff. or Rdway }				\$
28	Ft. 3/4 in. { Copper } { Galv. Iron } { Cast Iron } Pipe at				\$
	Nipples.....		in. at		\$
	Bushings.....		to..... in. at		\$
/	Red'g } Couplings..	3/4	to..... in. at		\$
	Incr				
	Union.....		in. at		\$
	Meter.....		in. at		\$
	Lbs. Br. Stone at.....				\$
	Lbs. Sand at.....				\$
	Bags Cement at.....				\$
	Paving Brick { Mack } { Red } { Asphalt } at.....				\$
	Lead Joints at.....				\$
	Leadite Joints at.....				\$
10	Hrs. Foreman at.....				\$
2	Hrs. Common Labor at.....	50			\$
14	Hrs. Common Labor at.....				\$
	Hrs. Mason at.....				\$
	Hrs. Mason's Helper at.....				\$
	Hrs. Compressor at.....				\$
	Compensation Ins.....				\$
	Trucking.....				\$
	Builders' Use of Water.....				\$
Total \$.....					

no 46 move over

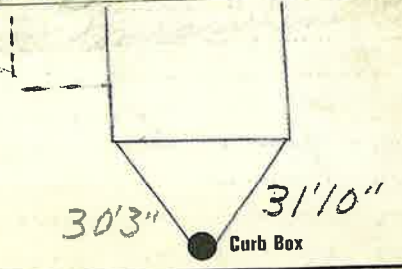

6" Main Elev. of Main at tap 5'

Gate at ● ● Gate at 28' to MAIN

● Curb Box

new House
new Job
Payments