

LABOR AND MATERIALS

Copper	} Connection	_____	\$ _____	
Lead				
Curb	} Cock	_____ in.	\$ _____	
				} Valve
Service box	} Short 3½ x 4½	_____	\$ _____	
				Long 4½ x 5½
Old returned				
7 Ft. 1 in.	} Pipe at	_____	\$ _____	
		<del>Copper</del>		
		<del>G. I.</del>		
	<del>C. I.</del>			
Nipples	_____ in. at	_____	\$ _____	
Bushings	_____ to _____ in. at	_____	\$ _____	
Red'g	} Coupl'gs	_____ to _____ in. at	\$ _____	
Inc'g				
Union	_____ in. at	_____	\$ _____	
Meter	_____ in. at	_____	\$ _____	
			\$ _____	
Compound Joints	at	_____	\$ _____	
Maintenance Foreman		_____	\$ _____	
Hrs. Water Maint. Man—1	at	_____	\$ _____	
Hrs. Water Maint. Man—2	at	_____	\$ _____	
Hrs. Garage Foreman	at	_____	\$ _____	
Hrs. Labor—	at	_____	\$ _____	
Hrs. Compressor	at	_____	\$ _____	
			\$ _____	
Trucking		_____	\$ _____	
Pav't Patch		_____	\$ _____	
			\$ _____	
			\$ _____	

*Drove*

~~St.~~  
~~Pl.~~  
Ave. No. *11*

Name of Owner \_\_\_\_\_

Labor and Mat'l. Report

*1923*

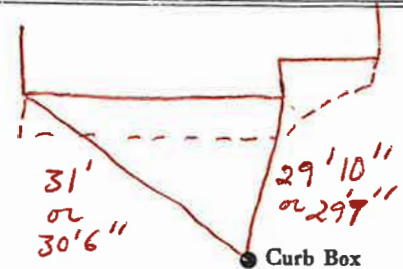

*6"* Main

Elev. of Main at tap *4'*

Gate at ●

● Gate at

● Curb Box

TAX ID # 302.20-2-17