

Labor and Materials


Copper } Connection		\$ 3.20
Lead } Connection		
Curb { Cock Valve } in.		\$ 1.00
Curb { T-S & V. }		
Service Box { Short 3" x 4" } Old returned { Long 4" x 5" } Buff. or Rdway		\$ 1.30
2.6 Ft. 3/4" in. { Copper Galv. Iron } Pipe at		\$ 5.72
Cast Iron		
Nipples	in. at	\$
Bushings	to in. at	\$.17
Red'g } Couplings	to in. at	\$.15
Inc'g }		
Union	in. at	\$
Meter	in. at	\$
Lbs. Br. Stone	at	\$
Lbs. Sand	at	\$
Bags Cement	at	\$
Paving Brick { Mack Red Asphalt } at		\$
Lead Joints	at	\$
Leadite Joints	at	\$
5 Hrs. Foreman at	6.75	\$ 3.12
13 Hrs. Common Labor at	50	\$ 6.50
15 Hrs. Common Labor at	40%	\$ 6.19
Hrs. Mason at		\$
Hrs. Mason's Helper at		\$
Hrs. Compressor at		\$
Compensation Ins.		\$
Trucking		\$ 1.00
Builders' Use of Water		\$
Payroll 15		Total \$

27-54

Labor and Material Report

June 2 1927

on 30 drive over

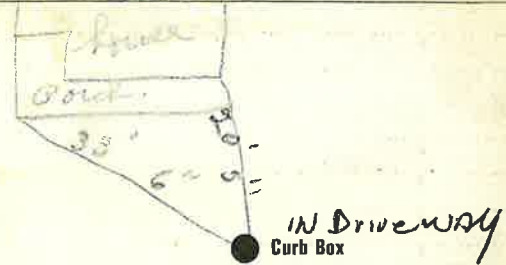

6" Main Elev. of Main at tap 5'

Gate at ● Gate at ●

● Curb Box

old job shut off.