

LABOR AND MATERIALS

1	Copper Lead	Connection	$\frac{3}{4}$		\$ 1.23
1	Curb	Cock Valve T. S. & V.	$\frac{3}{4}$	in.	\$ 1.68
1	Service Box Old returned	Short $3\frac{1}{2} \times 4\frac{1}{2}$ Long $4\frac{1}{2} \times 5\frac{1}{2}$ Buff. or Rdway			\$ 1.54
25 Ft.	$\frac{3}{4}$ in.	Copper Galv Iron Cast Iron		Pipe at 17	\$ 4.25
	Nipples	in. at			\$
	Bushings	to in. at			\$
	Red'g Inc'g	Couplings	to in. at		\$
	Union	in. at			\$
	Meter	in. at			\$
	Lead Joints	at			\$
	Leadite Joints	at			\$
	Hrs. Foreman	at			\$
5	Hrs. Chauffeur	at	62 1/2		\$ 3.13
6	Hrs. Tapper	at	"		\$ 3.75
22	Hrs. Labor	at	45		\$ 9.90
	Hrs. Labor	at			\$
3	Hrs. Compressor	at	62 1/2		\$ 1.88
	Compensation Ins.				\$.51
	Trucking				\$ 1.00
	Builders Use of Water	Patch			\$ 9.00
					\$
					\$
					\$ 37.87


45
5 - - 1939

St
Pl
Ave. No. 52

Grove

Name of Owner
Gorman Barber

Labor and Mat'l. Report Nov 28 1939

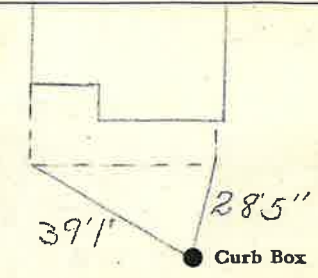

6 Main

Elev. of Main at tap. 1 1/2

Gate at ● ● Gate at

● Curb Box

old shut off